


ORIENTATION







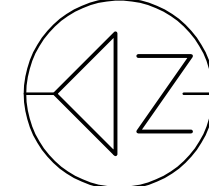





PLAN ONLY (APPROXIMATE)


CAUTION: DO NOT SCALE DRAWINGS.
THIS REPRODUCTION MAY BE AT A SIZE DIFFERENT THAN ORIGINALLY DRAWN. EXP ASSUMES NO RESPONSIBILITY FOR INCORRECT SCALING, UNAUTHORIZED REPRODUCTION OR REUSE IS STRICTLY PROHIBITED, NOT PUBLISHED - ALL RIGHTS RESERVED. EXP EXPRESSLY DISCLAIMS RESPONSIBILITY ARISING FROM UNAUTHORIZED USE OF THESE DRAWINGS AND NOTES. AUTHORIZATION MUST BE IN WRITING.

© exp, 2023

DIMENSIONS NOTES:
1. ALL DIMENSIONS ARE IN METERS (m) UNLESS NOTED OTHERWISE.

- LEGEND
-  FENCELINE
 -  LIMIT APPROVED FILL AREA
 -  LIMIT OF WASTE CELLS
 -  BOTTOM OF DITCH
 -  SEEPAGE SWALE
 -  EDGE OF PAVED ROAD
 -  EDGE OF GRAVEL ROAD
 -  EXISTING TOP OF SLOPE
 -  EXISTING TOE OF SLOPE
 -  PAVED SURFACE

CONTROL POINTS				
POINT #	NORTHING	EASTING	ELEV.	DESC.
102	5262607.7630	596977.2128	258.081	RIB
104	5262789.2940	596730.4836	272.040	RIB
110	5262635.8155	596743.6011	271.934	RIB
111	5262965.8789	596686.3400	272.293	RIB

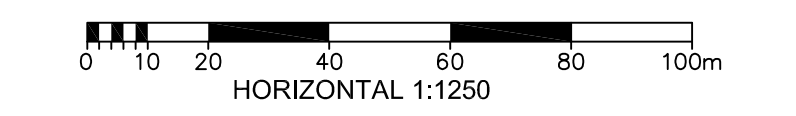

No.	DATE (YYYYMMDD)	REVISION	BY
1	23/10/24	AS CONSTRUCTED	GDW

CLIENT
CITY OF TEMISKAMING SHORES


PROJECT TITLE
NEW LISKEARD LANDFILL SITE EXPANSION

PROJECT No. **NWL-23012070**

DRAWING TITLE
AS CONSTRUCTED LANDFILL SITE

DESIGNED	SCALE
GDW	AS INDICATED
DRAWN	PLAN No.
EGL	22-1245
CHECKED	DRAWING No.
NJD	

EXP Services Inc.
 1-705-647-4311 | 1-705-647-3111
 310 Whitehead Ave. W.
 New Liskeard, ON P0J 1P0
 Canada
www.exp.com

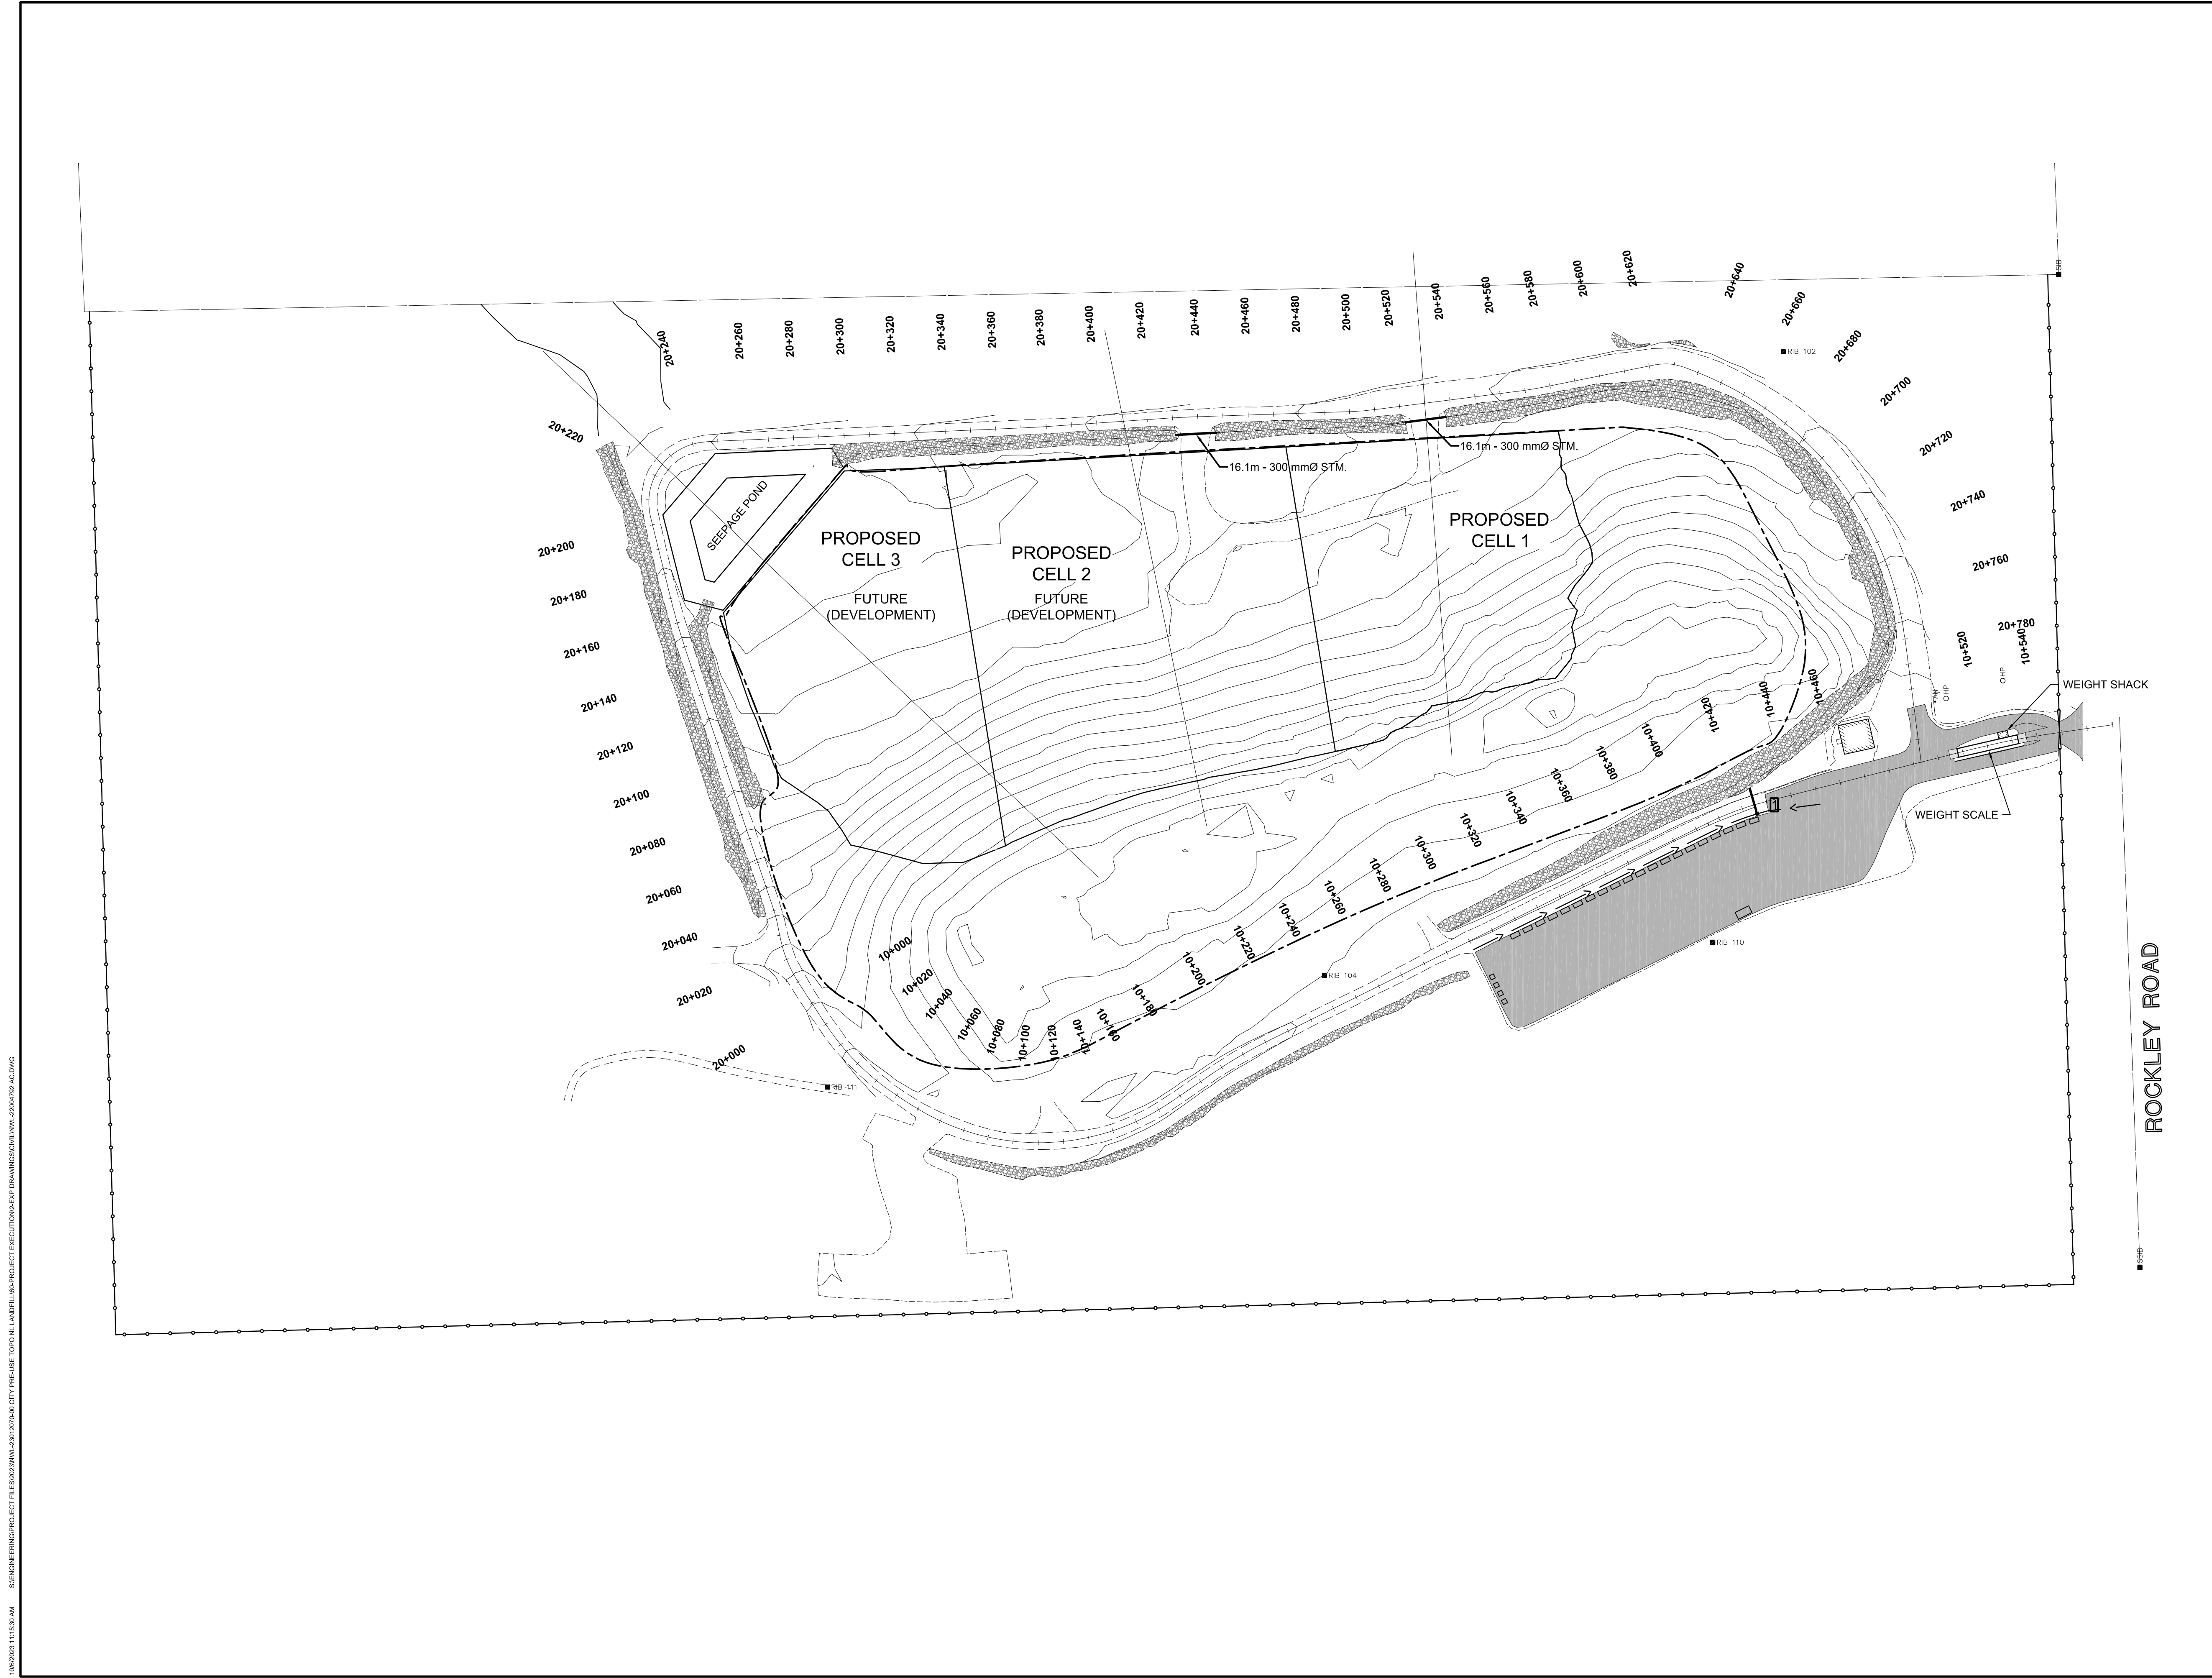10/02/23 11:52 AM S:\PROJECTS\2023\23012070\23012070.DWG PROJECT EXECUTIVE\DWG\EXP\23012070.DWG