

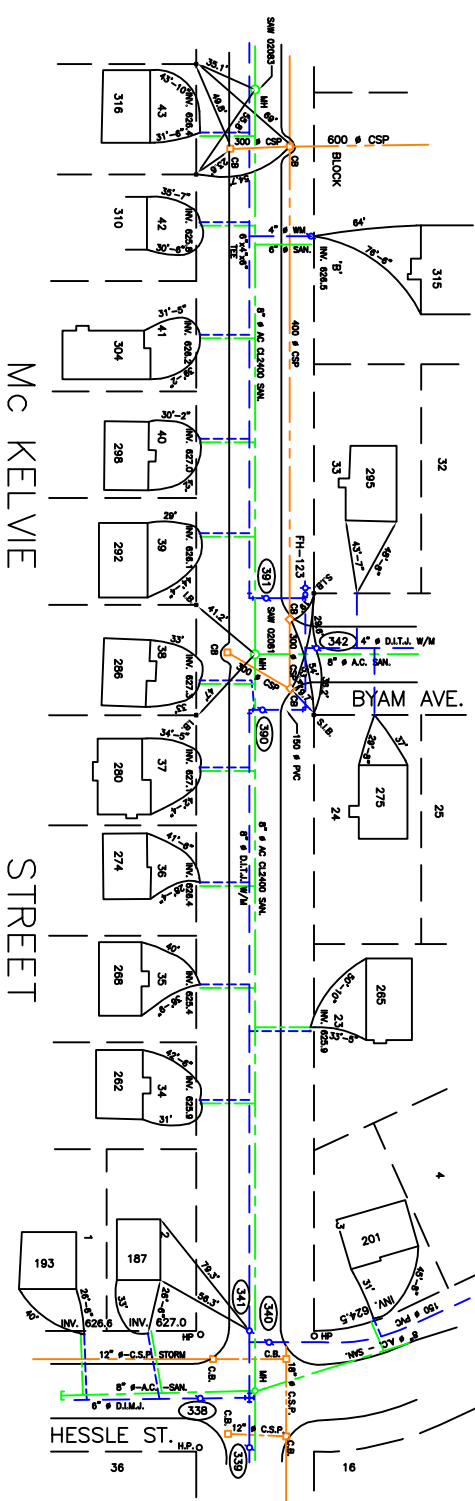


REMARKS	BY	DATE	PLAN NO.
AS CONSTRUCTED 1973	W.C.P.	1973	4-20
AS CONSTRUCTED 1980	W.C.P.	1980	4-21
AS CONSTRUCTED 1982	W.C.P.	1982	4-22
AS CONSTRUCTED 1983	W.C.P.	1983	4-23
AS CONSTRUCTED 1984	W.C.P.	1984	4-24
AS CONSTRUCTED 2020	W.C.P.	2020	4-60

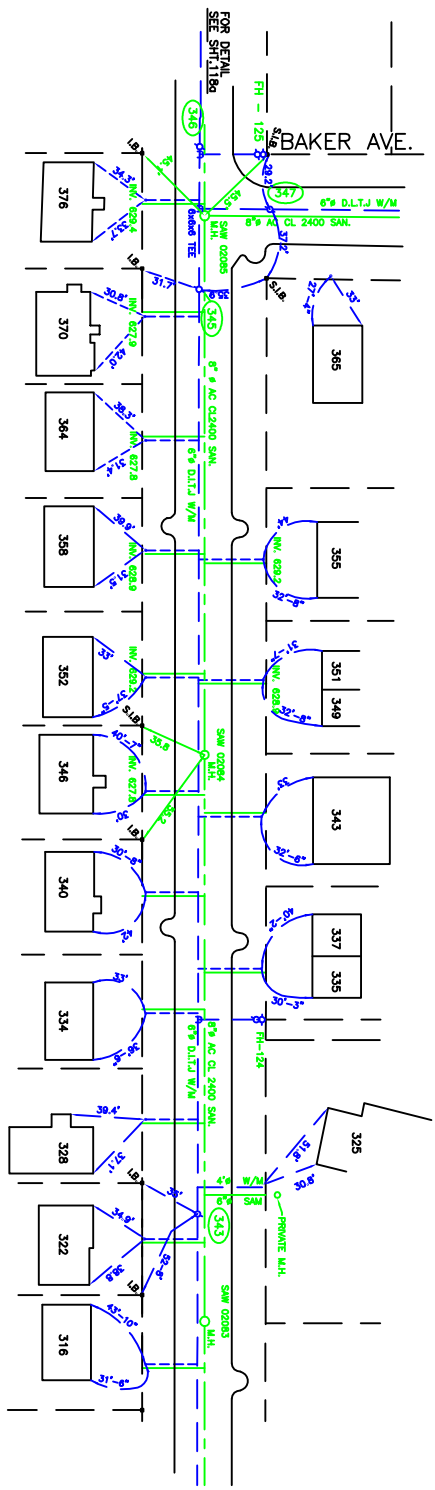

Mc KELVIE STREET

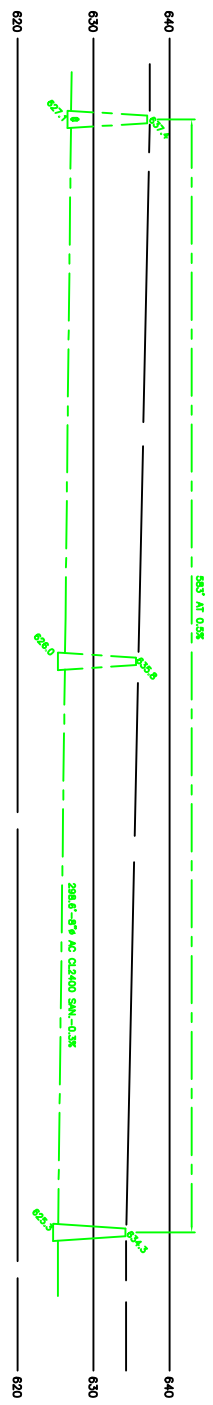

REMARKS	BY	DATE	PLAN NO.
AS CONSTRUCTED 1972	W.E.	1972	4-20
AS CONSTRUCTED 1977	W.E.	1977	
HOUSE NOS 1980			

